

RFP D/B - Roseville Power Plant #2 Repower

<u>Category:</u>	Power Plants and Lines	<u>Project ID #:</u>	1007393707
<u>Street Address:</u>	2115 Nichols Dr Rocklin CA 95765	<u>Staff Estimate Value</u>	\$600,000.00
<u>County:</u>	Placer	<u>Stage:</u>	BIDDING - Biddate Set
<u>Bid Date:</u>	1/21/2025 , 03:00PM		
<u>Architect:</u>			
<u>Documents Available:</u>	Plans, Specs, Addenda available in Insight	Plans available from City of Roseville	
<u>Last Update:</u>	12/4/2024	New Biddate is 01/21/2025	

Project Description

Scope

Renovation of a power facility in Rocklin, California. Completed plans call for the renovation of a power facility. The City of Healdsburg (City) is seeking bids from qualified suppliers of bulk chemicals including Citric Acid, Sodium Chloride (Salt), Sulfuric Acid, and Liquid Sodium Hypochlorite for delivery to various City facilities located in Healdsburg, California. It is the responsibility of the successful Bidder to ensure that the services are delivered to the City as per specifications and provisions listed and agreed to herein. It is the City's intent that this IFB shall result in a firm, fixed price contract for an initial term of three (3) years with the successful Bidder. Upon mutual agreement of City and Contractor, the resulting awarded contract shall allow for an annual unit price adjustment to the bid rates for inflation based on the Engineering News Record's 20-Cities Construction Cost Index in June of each year. Council Award December 16, 2024 The City of Healdsburg reserves the right to postpone the date and time for the opening of proposals at any time prior to the date and time announced in the advertisement in accordance with applicable law. The City of Healdsburg reserves the right to reject any and all bids or to waive any defects or irregularity in bidding in accordance with applicable law, the contract shall be awarded to the lowest responsive bidder, on basis of the total base bid amount as listed in the proposal. The bidder must meet the terms of the specifications. All bids will remain valid for 90 days after the bid opening.

Notes

Development include(s): Renovation Bid Date: 01/21/2025 03:00PM Bid date changed from 01/02/2025 as per Addendum 1. Proposals will be accepted ONLY at the office of the City Clerk, Civic Center, 311 Vernon Street, Roseville, CA 95678 or submitted via electronic mail to CityClerkroseville@roseville.ca.us. Said proposals will be evaluated and results will be made public after completion of the negotiation process with the selected contractor. Request For Proposal - RFP: 01/21/2025 03:00PM Proposals will be accepted ONLY at the office of the City Clerk, Civic Center, 311 Vernon Street, Roseville, CA 95678 or submitted via electronic mail to CityClerkroseville@roseville.ca.us. Said proposals will be evaluated and results will be made public after completion of the negotiation process with the selected contractor. Mandatory Site Walkthrough: 11/20/2024 08:00AM The job walk will start at the Roseville Energy Park located at 5120 Phillip Road, Roseville CA where a tour of similar TM2500s will be given. Afterward traveling to the job site at 2115 Nichols Road, Rocklin, CA. A mandatory pre-proposal conference/job walk has been scheduled. All prospective bidders are encouraged to pre-register for the job walk by contacting Ozro Corulli at ocorulli@roseville.ca.us. The job site will be visited to preview the project areas, locations, and accessibility. Site Walkthrough: 12/11/2024 08:00AM Site walkthrough event Added as per Addendum 2.

Details

[Division 2]: Earthwork, Grading, Paving & Surfacing, Water Systems, Wells, Sewerage & Drainage. [Division 3]: Concrete Formwork, Concrete Reinforcement, Structural Concrete. [Division 4]: Stone. [Division 5]: Structural Steel, Metal Fabrications. [Division 7]: Insulation, Firestopping. [Division 9]: Painting. [Division 10]: Louvers & Vents. [Division 11]: Parking Control Equipment. [Division 14]: Elevators, Material Handling Systems. [Division 15]: Mechanical Insulation, Boilers, Air Handling, Ductwork. [Division 16]: Service/Distribution, UPS Systems, Standby Power Generator Systems, Voice & Data Systems.

Project Events

Event	Date	Details
End Date	6/1/2026	
Start Date	2/21/2025	Estimated Start Date

Request For Proposal - RFP - Design-Build	1/21/2025 , 03:00PM	Proposals will be accepted ONLY at the office of the City Clerk, Civic Center, 311 Vernon Street, Roseville, CA 95678 or submitted via electronic mail to CityClerkroseville@roseville.ca.us. Said proposals will be evaluated and results will be made public after completion of the negotiation process with the selected contractor.
Bid Date	1/21/2025 , 03:00PM	Bid date changed from 01/02/2025 as per Addendum 1. Proposals will be accepted ONLY at the office of the City Clerk, Civic Center, 311 Vernon Street, Roseville, CA 95678 or submitted via electronic mail to CityClerkroseville@roseville.ca.us. Said proposals will be evaluated and results will be made public after completion of the negotiation process with the selected contractor.
Site Walkthrough	12/11/2024 , 08:00AM	Site walkthrough event Added as per Addendum 2.
Site Walkthrough	11/20/2024 , 08:00AM	Mandatory: The job walk will start at the Roseville Energy Park located at 5120 Phillip Road, Roseville CA where a tour of similar TM2500s will be given. Afterward traveling to the job site at 2115 Nichols Road, Rocklin, CA. A mandatory pre-proposal conference/job walk has been scheduled. All prospective bidders are encouraged to pre-register for the job walk by contacting Ozro Corulli at ocorulli@roseville.ca.us. The job site will be visited to preview the project areas, locations, and accessibility.

Additional Details

Listed On:	11/11/2024	Floor Area:	
Contract Type:		Work Type:	Alteration
Stage Comments 1:		Floors Below Grade:	
Stage Comments 2:		Owner Type:	City
Bid Date:	1/21/2025	Mandatory Pre Bid Conference:	
Invitation #:	07-109	Start Date:	2/21/2025
Structures:	1	Completion Date:	6/1/2026
Single Trade Project:		Site Area:	
Floors Above Grade:		LEED-Registered Project:	
Parent Project ID:		Units:	
Parking Spaces:			

Design Team




Company Role	Company Name	Contact Name	Contact Status	Address	Phone	Email	Fax
Civil Engineer	IEC Corporation			8795 Folsom Blvd. Suite 205, Sacramento, CA 95826	(916) 383-6000		(916) 383-6010
Owner	City of Roseville	Ozro Corulli	Active	311 Vernon St. , Roseville, CA 95678	(916) 774-5586	ocorulli@roseville.ca.us	(916) 774-5129

Buyer Activity Report

Status	Activity Level	Contact	Company Name	Source	Phone	Email	Business Type	Trades	Last Active
New		Nancy Smith	Best Western Roseville Inn		(916) 782-4434	nsmith@heritagehotelgroup.com	Subcontractor	Industry-Specific Manufacturing Equipment	11/25/2024

Contracts

Classification	Conditions	Bonding	Bid Date	Bids To	Bid Type
General Contractor		Perf:100.00%,Pay:10 0.00%	1/21/2025	Owner	Open Bidding

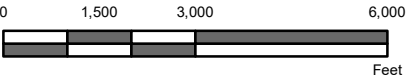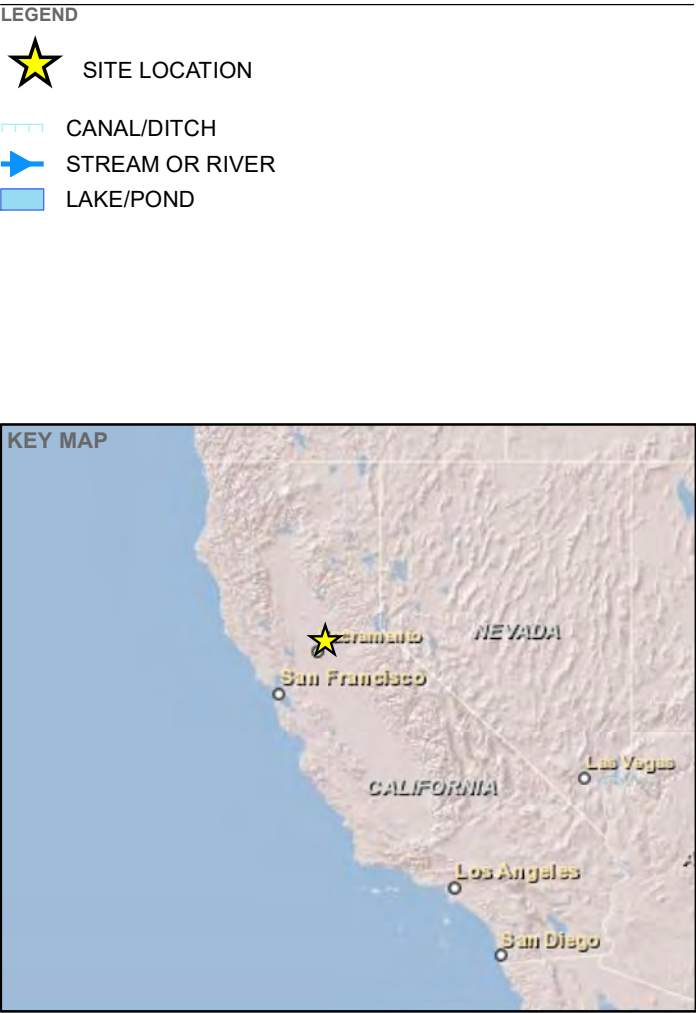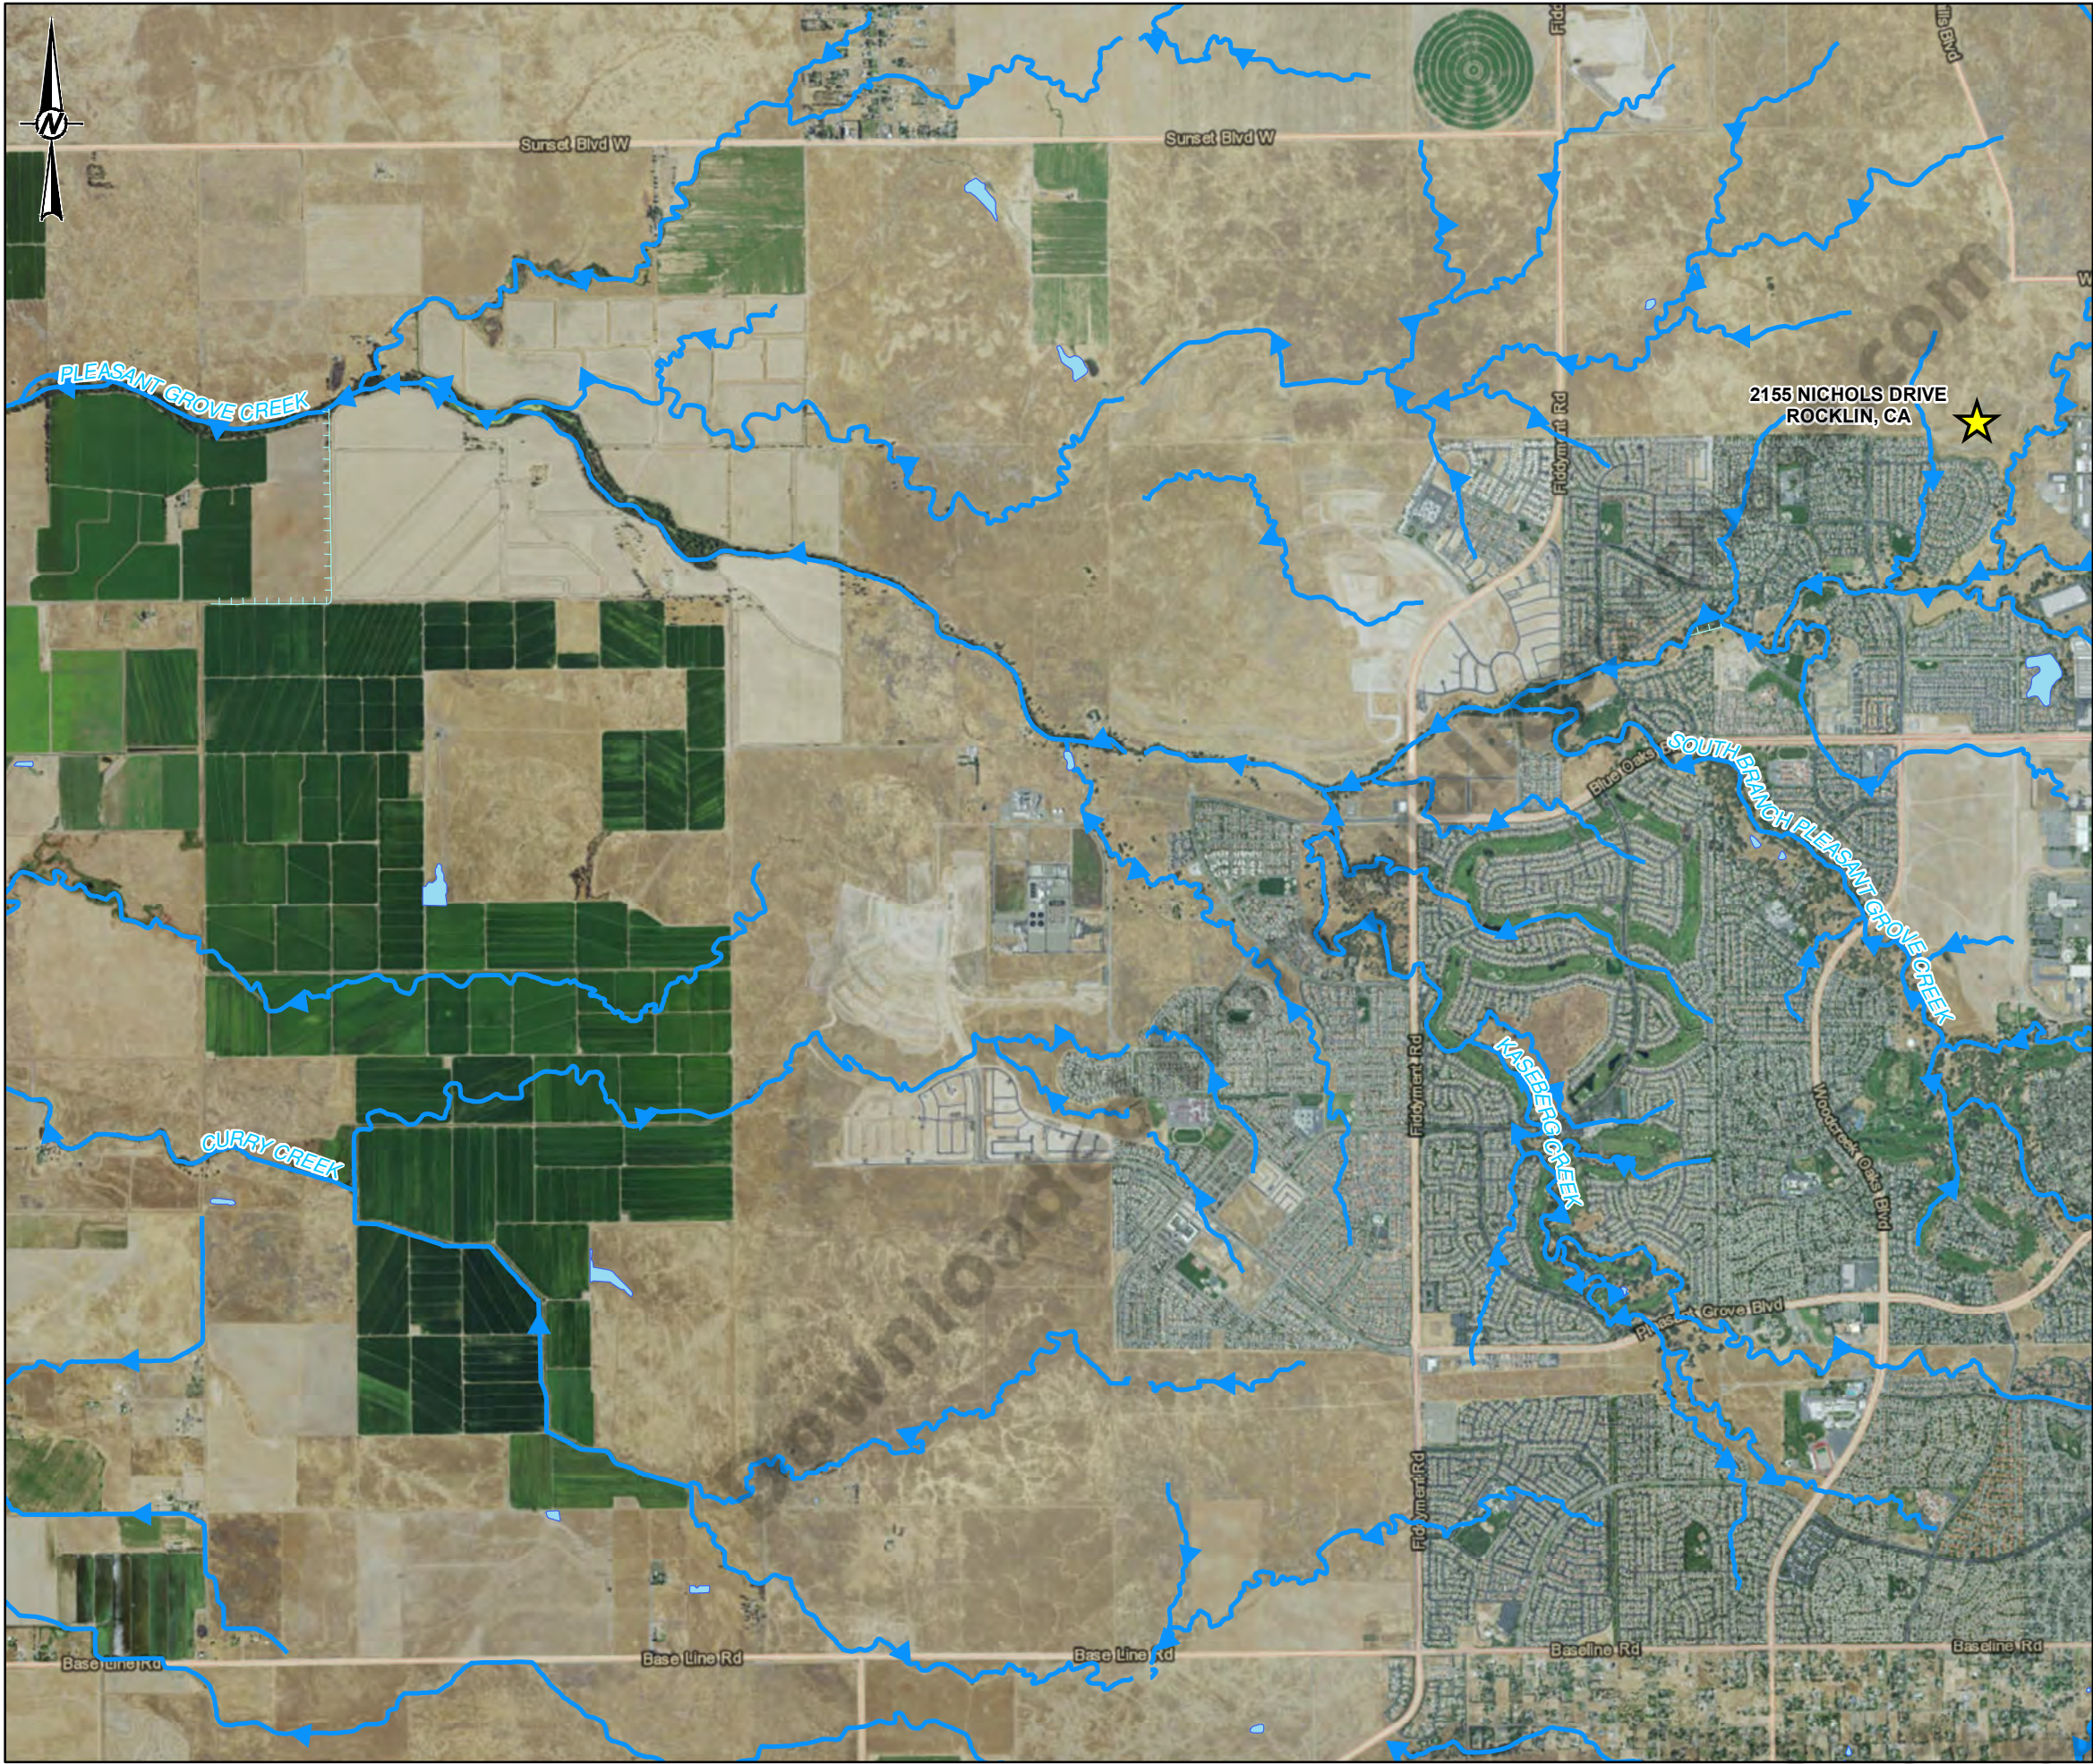

REFERENCE(S)
1. AERIAL IMAGERY AND ROAD NAMES OBTAINED FROM ESRI BASEMAP WEB SERVICE TITLED WORLD_IMAGERY, BASED ON MICROSOFT BING. DATE OF IMAGERY: FEBRUARY 2, 2012.


CLIENT
CITY OF ROSEVILLE
2090 HILLTOP CIRCLE
ROSEVILLE CA 95747

PROJECT
SPILL PREVENTION CONTROL AND COUNTERMEASURES PLAN
ROSEVILLE POWER PLANT #2
2155 NICHOLS DRIVE

TITLE
SITE VICINITY

CONSULTANT	YYYY-MM-DD	2015-06-05
DESIGNED	JDR	
PREPARED	JDR	
REVIEWED	BJ	
APPROVED	EC	

PROJECT NO. 1539951
REV. 0
FIGURE 1

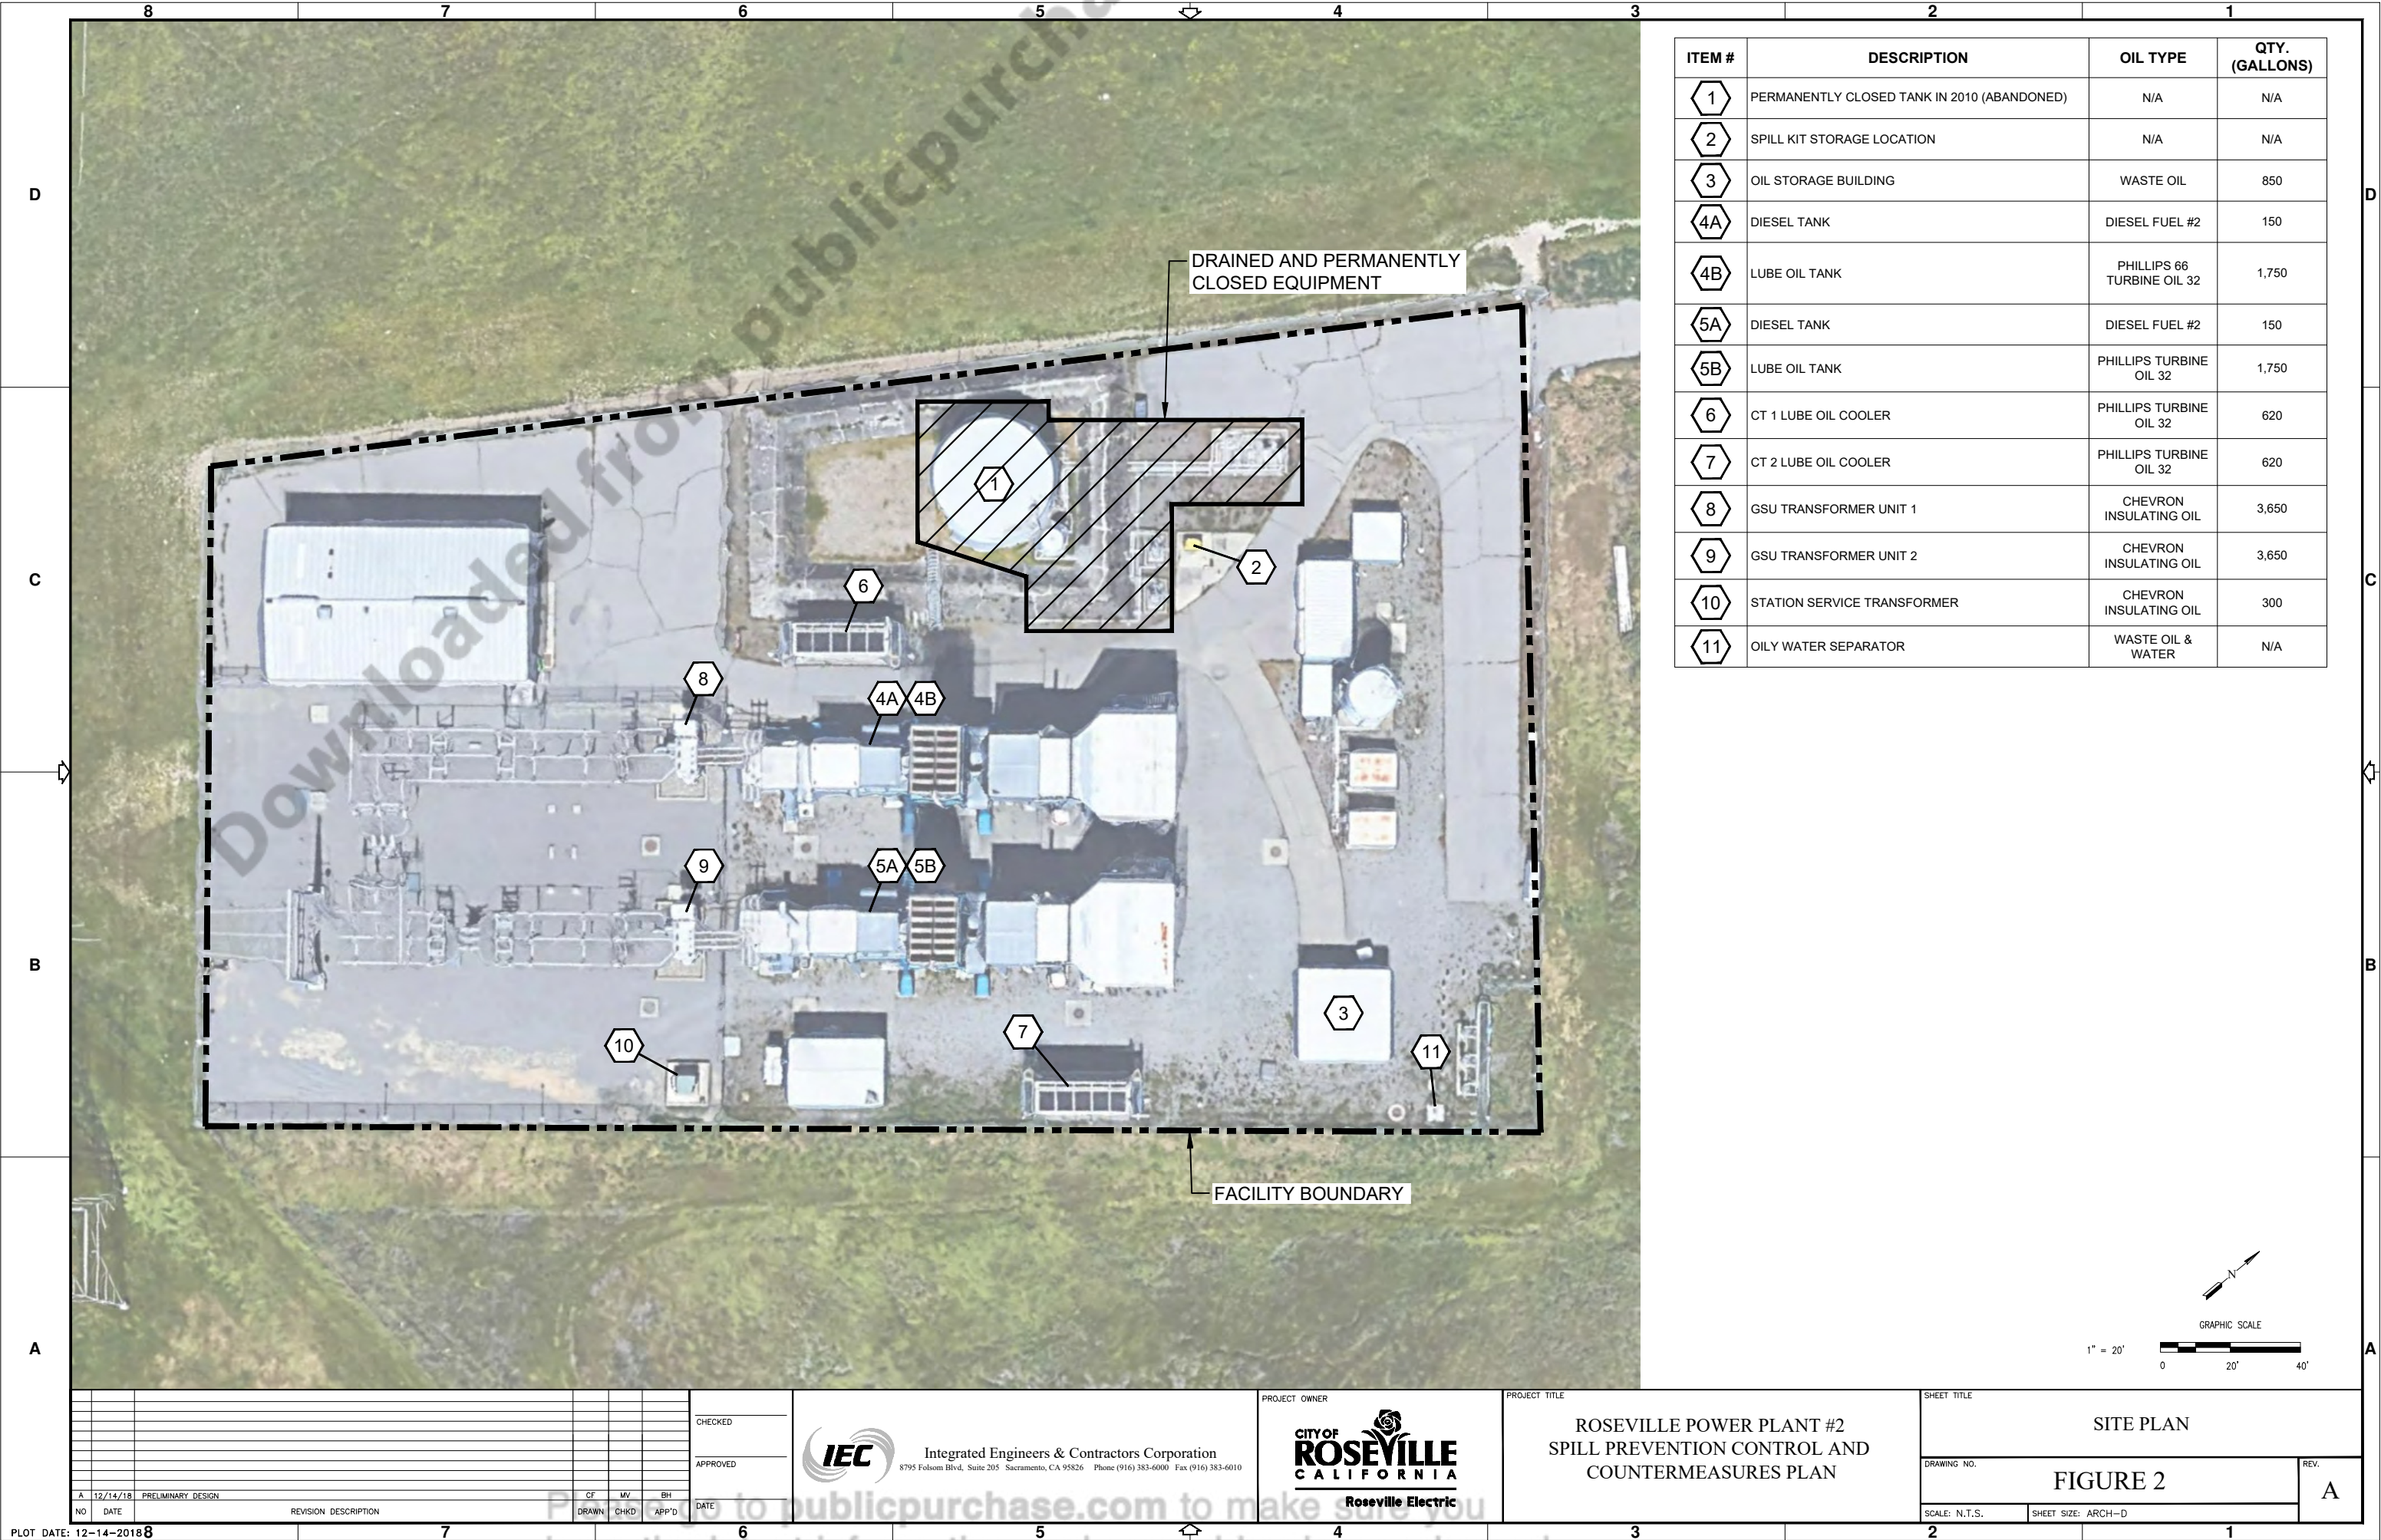

ITEM #	DESCRIPTION	OIL TYPE	QTY. (GALLONS)
1	PERMANENTLY CLOSED TANK IN 2010 (ABANDONED)	N/A	N/A
2	SPILL KIT STORAGE LOCATION	N/A	N/A
3	OIL STORAGE BUILDING	WASTE OIL	850
4A	DIESEL TANK	DIESEL FUEL #2	150
4B	LUBE OIL TANK	PHILLIPS 66 TURBINE OIL 32	1,750
5A	DIESEL TANK	DIESEL FUEL #2	150
5B	LUBE OIL TANK	PHILLIPS TURBINE OIL 32	1,750
6	CT 1 LUBE OIL COOLER	PHILLIPS TURBINE OIL 32	620
7	CT 2 LUBE OIL COOLER	PHILLIPS TURBINE OIL 32	620
8	GSU TRANSFORMER UNIT 1	CHEVRON INSULATING OIL	3,650
9	GSU TRANSFORMER UNIT 2	CHEVRON INSULATING OIL	3,650
10	STATION SERVICE TRANSFORMER	CHEVRON INSULATING OIL	300
11	OILY WATER SEPARATOR	WASTE OIL & WATER	N/A

IEC

Integrated Engineers & Contractors Corporation

8795 Folsom Blvd, Suite 205 Sacramento, CA 95826 Phone (916) 383-6000 Fax (916) 383-6010




PROJECT TITLE

ROSEVILLE POWER PLANT #2
SPILL PREVENTION CONTROL AND
COUNTERMEASURES PLAN

SHEET TITLE	
SITE PLAN	
DRAWING NO.	REV.
FIGURE 2	A
SCALE: N.T.S.	SHEET SIZE: ARCH-D





NO		DATE	REVISION DESCRIPTION	CF	MV	BH
DRAWN		CHKD	APP'D	DATE		
A		12/14/18	PRELIMINARY DESIGN			

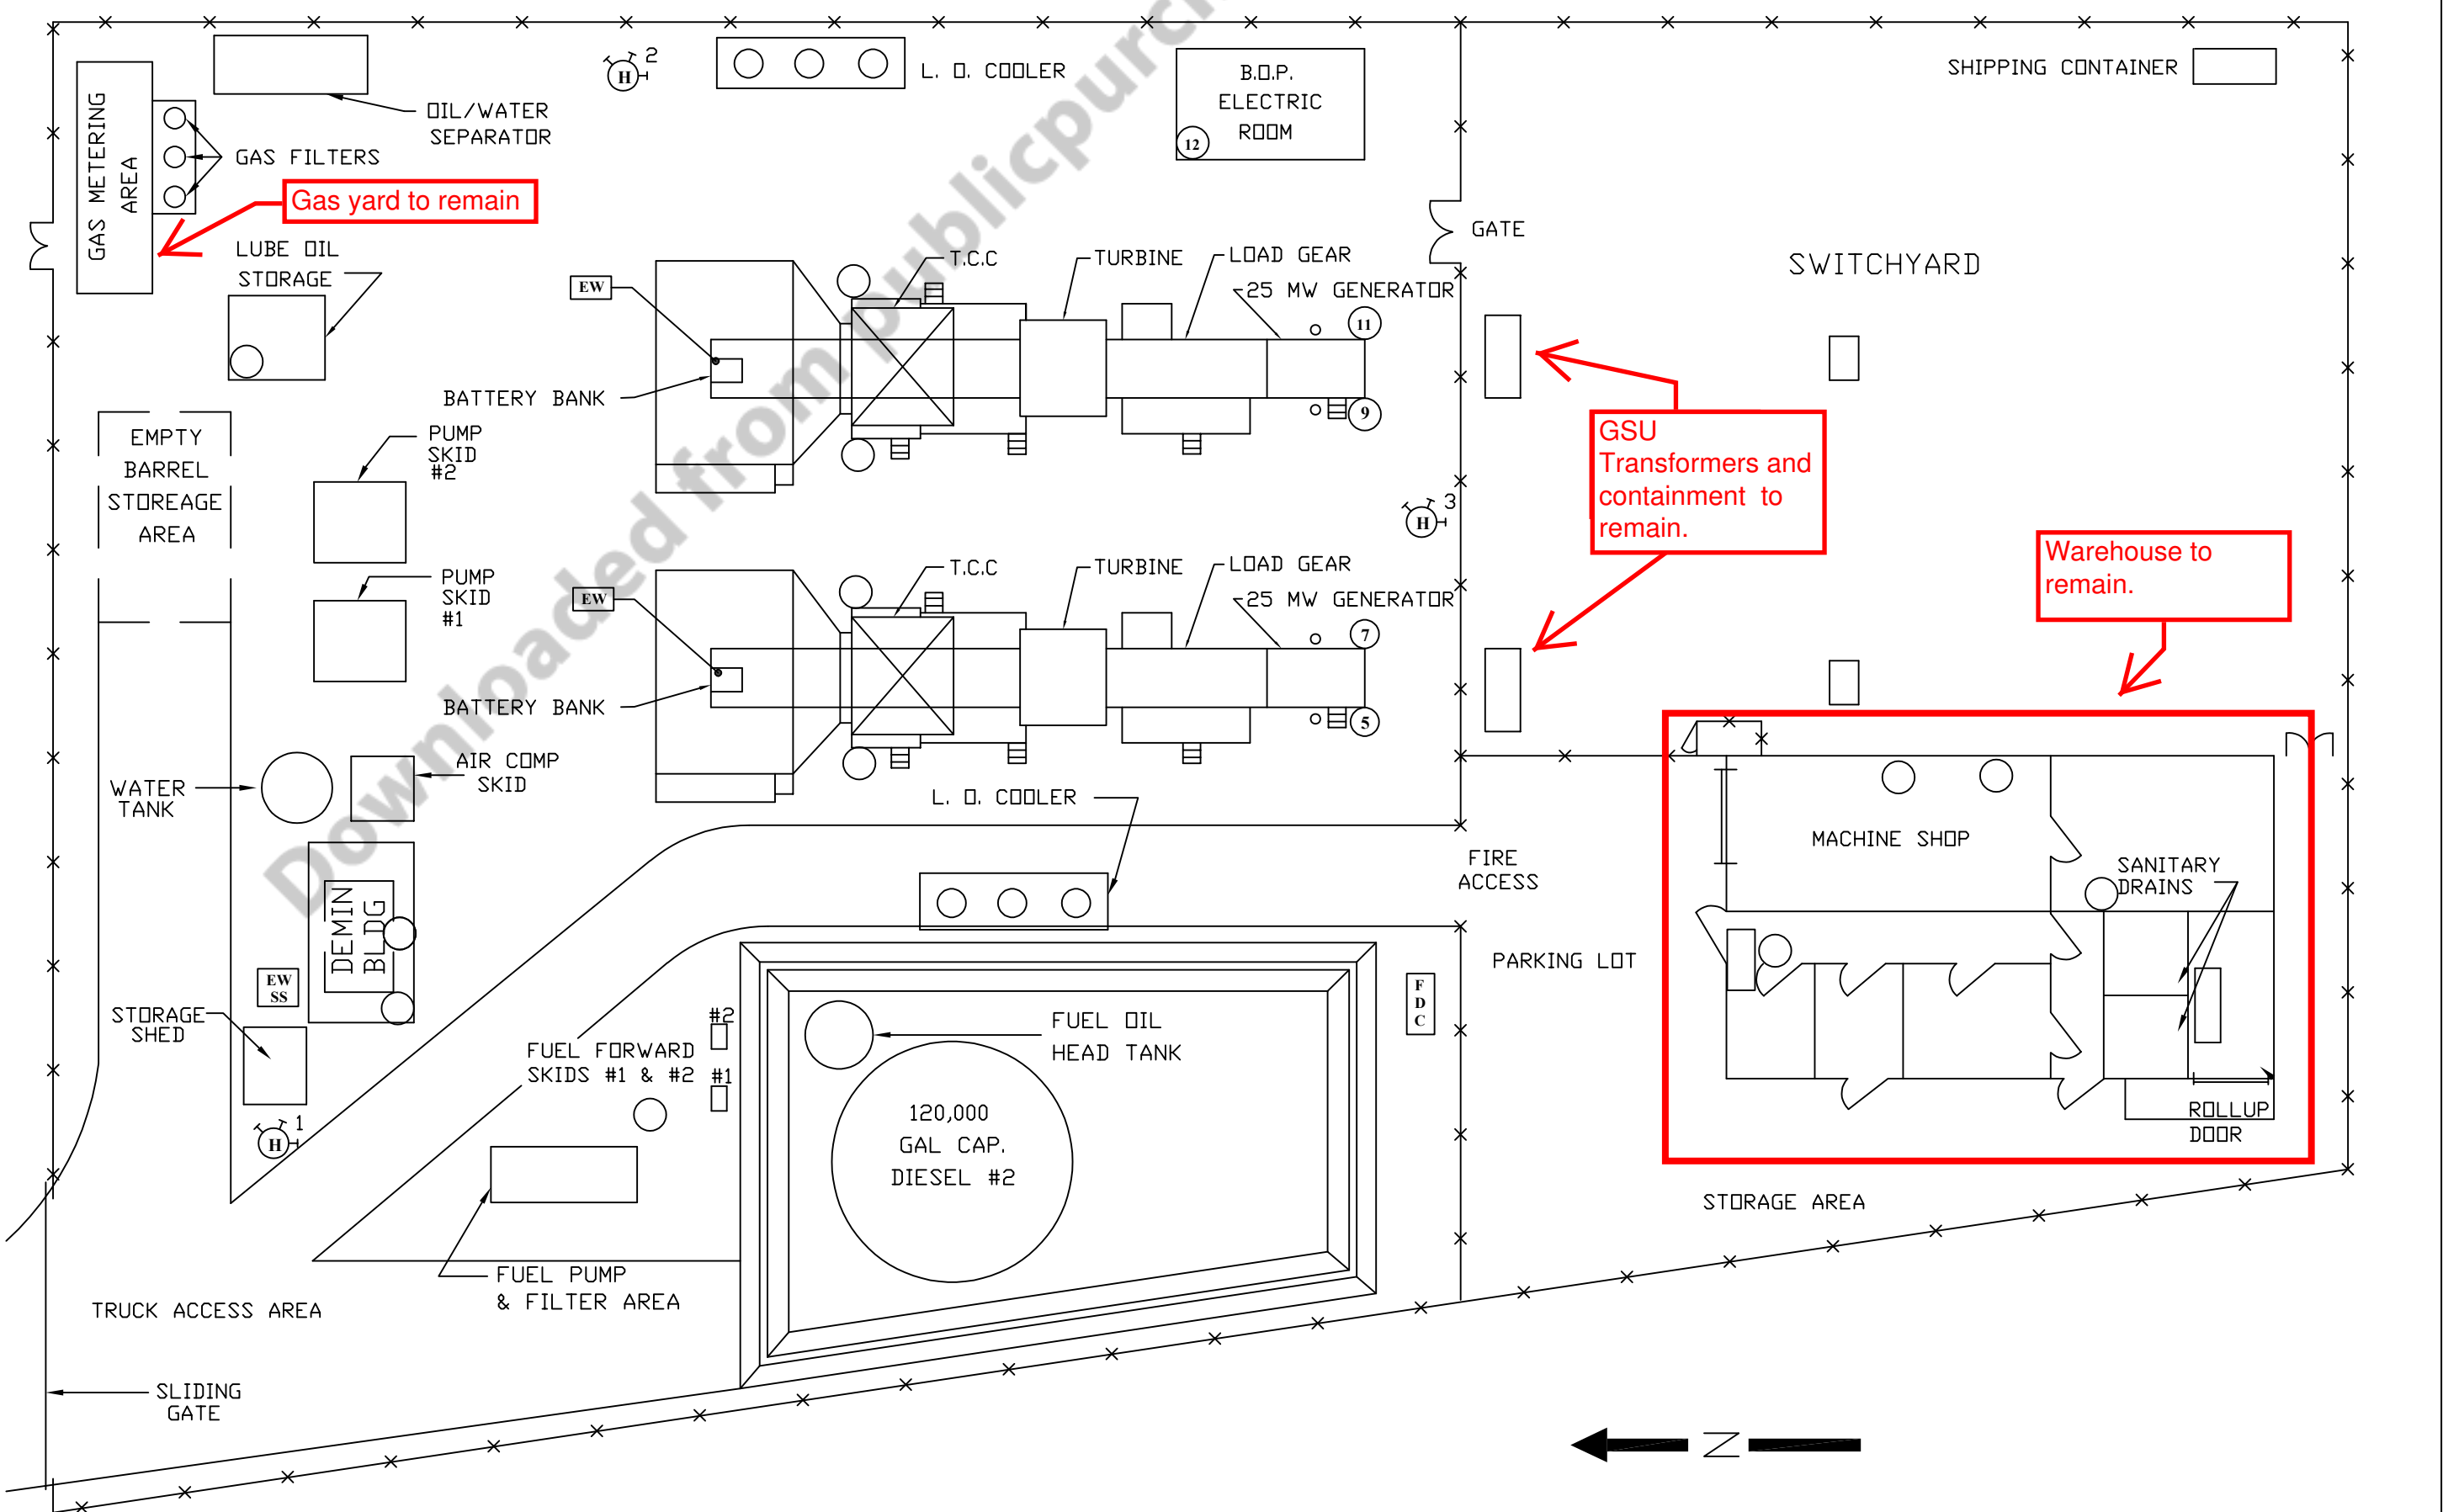


1				5				DOS FILE: M-161F.DWG		SIZE: B	NORTHERN CALIFORNIA POWER AGENCY ROSEVILLE GENERAL ARRANGEMENT	DWG. NO.	SCALE:
2				6				RDR. BY J LAWSON	CLASS:	M-161D		NONE	
3				7									
4				8				APPD.					
NO.	DATE	BY	REVISION	N0.	DATE	BY	REVISION	DATE	11/09/99				SHEET NO.
												1	





C-360

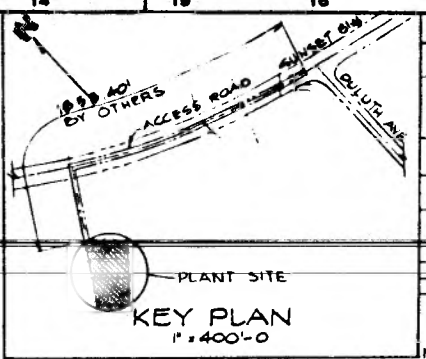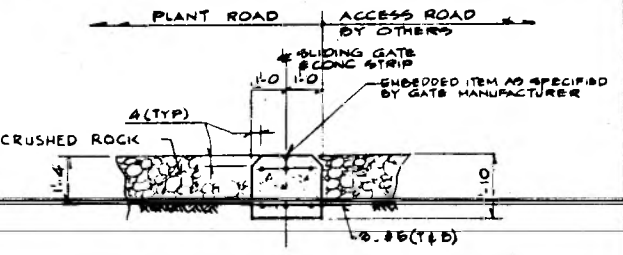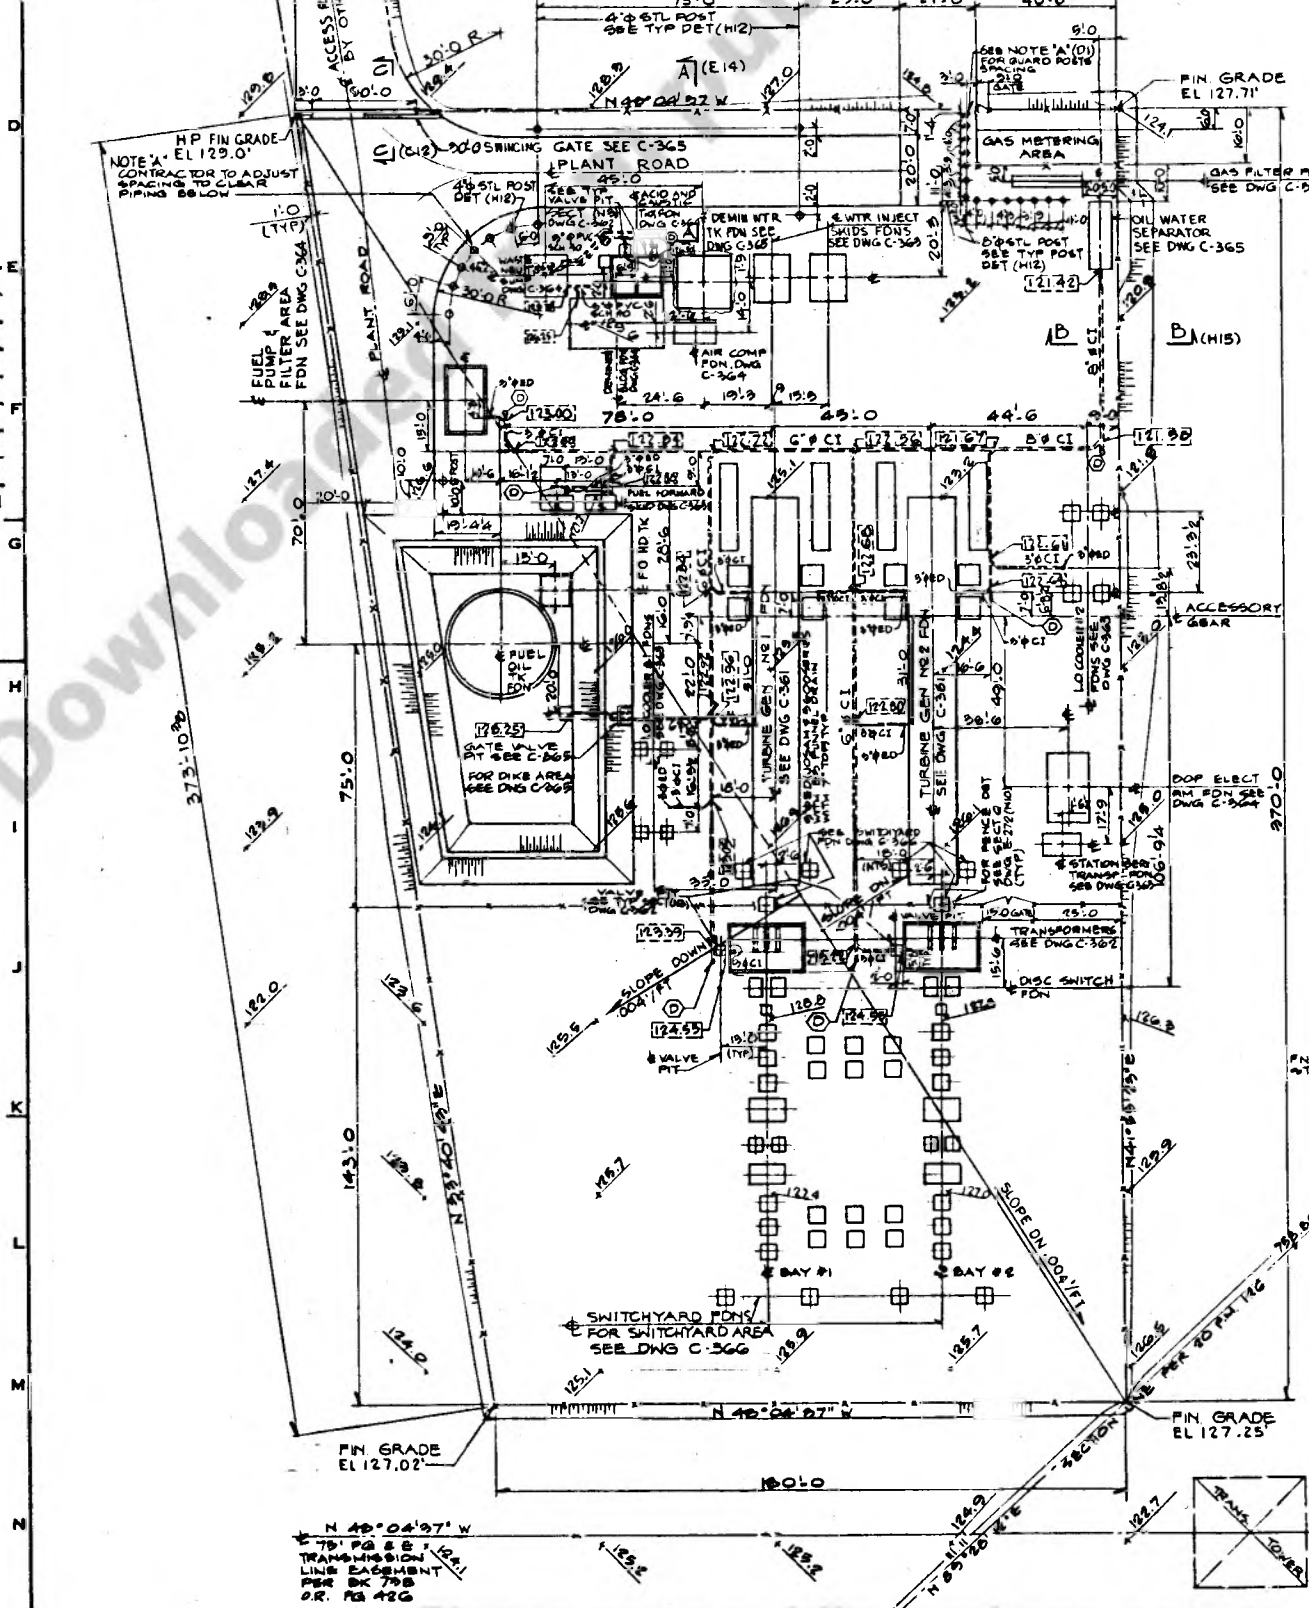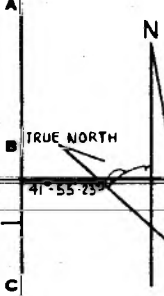

SECTION C (03)
1/2 x 1/0

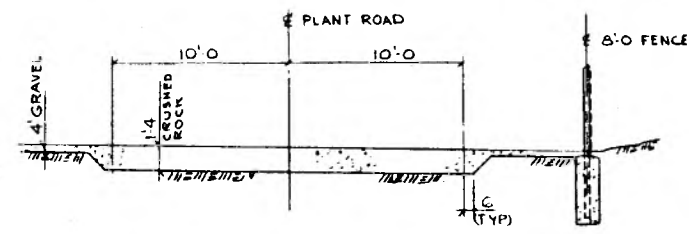

SECTION A (C6)
1/4 x 1/0

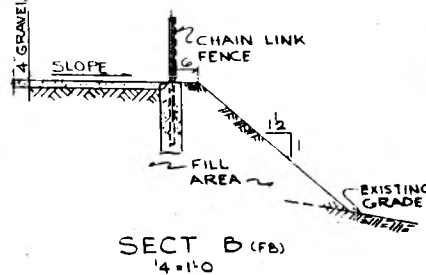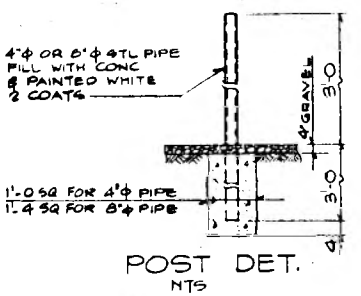

SECTION B (FB)
1/4 x 1/0

NO	DATE	REVISION	BY	CH	APPROVED
1	7/1/85	GENERAL REVISION REVISED FOR CONSTRUCTION	LN	SC	4P
2	7/1/85	ADDED (10) PIPES REVISED (10) PIPES REVISED (10) PIPES REVISED (10) PIPES REVISED (10) PIPES	LN	SC	4P
3	8/1/85	ADDED (10) PIPES REVISED (10) PIPES REVISED (10) PIPES REVISED (10) PIPES REVISED (10) PIPES	LN	SC	4P
4	8/1/85	ADDED (10) PIPES REVISED (10) PIPES REVISED (10) PIPES REVISED (10) PIPES REVISED (10) PIPES	LN	SC	4P
5	8/1/85	ADDED (10) PIPES REVISED (10) PIPES REVISED (10) PIPES REVISED (10) PIPES REVISED (10) PIPES	LN	SC	4P
6	8/1/85	ADDED (10) PIPES REVISED (10) PIPES REVISED (10) PIPES REVISED (10) PIPES REVISED (10) PIPES	LN	SC	4P
7	8/1/85	ADDED (10) PIPES REVISED (10) PIPES REVISED (10) PIPES REVISED (10) PIPES REVISED (10) PIPES	LN	SC	4P

NOTES

FOR EXCAVATION, BACKFILL, FILLING AND GRADING SEE EBASCO SPECIFICATION LA-510-84.

FOR CONCRETE FOR SMALL WORK SEE EBASCO SPECIFICATION LA-542-84.

FOR FENCE AND GATES SEE EBASCO SPECIFICATION LA-516-84. PROVIDE 3 STRAND BARBED WIRE EXTENSION AT TOP OF FENCE AND GATES.

FOR INSTALLATION OF DRAIN PIPE AND CULVERTS SEE EBASCO SPECIFICATION 2494-C5.

ORIGIN OF COORDINATES SYSTEM AND EXISTING TOPOGRAPHY IS BASED ON A TOPOGRAPHIC SURVEY PREPARED BY MORTON & PITLALO INC., CIVIL ENGINEERS AND SURVEYORS.

MINIMUM GROUND SLOPE SHALL BE .003 FT. PER FT.

FINISH GRADE ELEVATION INCLUDES THE 4" GRAVEL.

DRAINAGE PIPES CALLED OUT AS CI DEMOTES CAST IRON PIPE SPECIFICATION ASTM A74.

FOR CATHODIC PROTECTION REQUIREMENTS OF ALL CAST IRON TO CAST IRON JOINTS IN THE DRAINAGE SYSTEM SEE DWG E-258.

FOR DETAILS OF DIKE AREA SEE DWG C-365.

FOR AREA LIGHTING POLE LOCATIONS SEE DWG E-262.

FOR DETAILS OF CHAIN LINK FENCE AND GATE SEE DWG C-365.

ROAD PAVING TO CONSIST OF 1'-4" OF COMPACTED CRUSHED STONE.

FOR ADDITIONAL NOTES SEE DWG C-362.

REFERENCE DRAWINGS

TURBINE GENERATOR FDN SECTS AND DETAILS C-361

MISC FOUNDATIONS & DETAILS C-363

BOP ELECTRICAL ROOM, WATER TREATMENT AREA, SUMP & PUMPS FOUNDATIONS C-364

FUEL OIL TANK AREA FDN AND DIKE SECTIONS AND DETAILS C-365

SWITCHYARD FDN PLAN, SECTS & DETS C-366

TURBINE GENERATOR FDN A.B. & MISC FDN C-362

STATION LIGHTING E-262

STATION CATHODIC PROTECTION E-258

60KV SWITCHYARD SECTS & DETS E-272

LEGEND

SLOPE DN FINISH GRADE ELEVATION (INCLUDES GRAVEL)

EXISTING GRADE ELEV

INVERT ELEVATION OF PIPE

EQUIPMENT DRAINAGE PIPE AND FLOW DIRECTION

EQUIPMENT DRAIN CLEARDOUT TO GRADE

CHAIN LINK FENCE

CI CAST IRON PIPE



NORTHERN CALIFORNIA POWER AGENCY
PEAKING COMBUSTION TURBINE PROJECT
ROSEVILLE, CALIFORNIA
1985-24.8MW FOR UNIT 1
1986-24.8MW FOR UNIT 2
AREA GRADING, DRAINAGE,
ACCESS ROAD AND FOUNDATION PLAN

EBASCO SERVICES INCORPORATED		
SCALE 1/2" = 10' UN	APPROVED	DATE 5-3-85
DIV. CIVIL	LN	NCPA-2946
DR. LN/SC	LN	C-360
CH. SUFFARD	LN	



NOTES

REFERENCE DWGS.	
AREA GRADING, DRAINAGE, ACCESS ROAD & FDN PLAN	C-360
TURBINE GENERATOR FDN ANCHOR BOLTS & MISC. DETAILS	C-362



17 18 19

N-

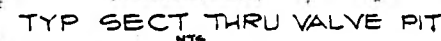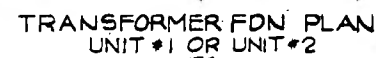

MANUFACTURER'S DRAWINGS.	
TURBO GENERATOR FOUNDATION KEY PLAN	2946-006
SPECIFICATION FOUNDATION NOTES	2946-012
FOUNDATION BOLTS FOR MSS501	2946-014
GENERATOR PLATES LAYOUT	2946-015
CONTROL CABINET FOUNDATIONS	2946-078
AIR FILTER FOUNDATIONS	2946-033
INLET DUCT FOUNDATION	2946-034



REV.

EBASCO SERVICES INCORPORATED

SCALE 3/16 x 1/8 UN	APPROVED	DATE 4/15/85
DIV. CIVIL	<i>et per</i>	NCPA-2946
DR. CUFFARO	<i>1/1/85</i>	C-362
CH. AJP		

NOTES.

FOR GENERAL NOTES SEE DWG C-360

PLANT EL 128.00' EQUALS DATUM EL 0.00'



ELEVATIONS SHOWN ON BRASS CATALOGS FOR GRADE AND TOP OF FOUNDATIONS TAKE PRECEDENCE OVER ELEVATIONS SHOWN ON MANUFACTURERS DRAWINGS.

FOR ADDITIONAL NOTES SEE DWG C-361

MANUFACTURER'S DRAWINGS	
FUEL FORWARDING SKID FOUNDATIONS	2946-010
OIL COOLER FOUNDATION	2946-035
WATER INJECTION SKID FOUNDATION	2946-049

LEGEND:



* CONTRACTOR ITEM - CONTRACTOR TO VERIFY FOUNDATION DIMENSIONS AND PROVIDE EQUIPMENT ANCHOR BOLTS AND OTHER EMBEDDED ITEMS AS PER VENDOR INFORMATION.

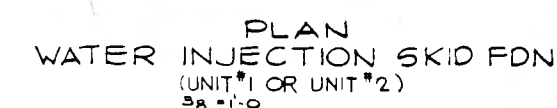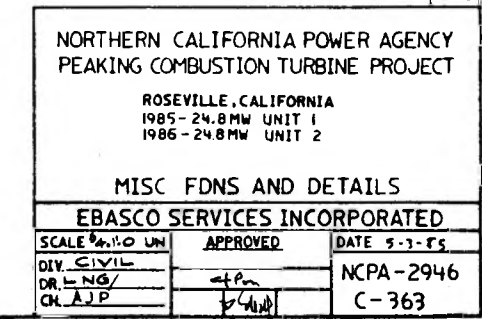

SECTION G (P.3.13)

Labels and dimensions in the diagram include:

- AB SEE VENDOR
- DWG 294G-055
- TOC BLOOD
- 1.5
- 0
- 4 GR EW (T & B)

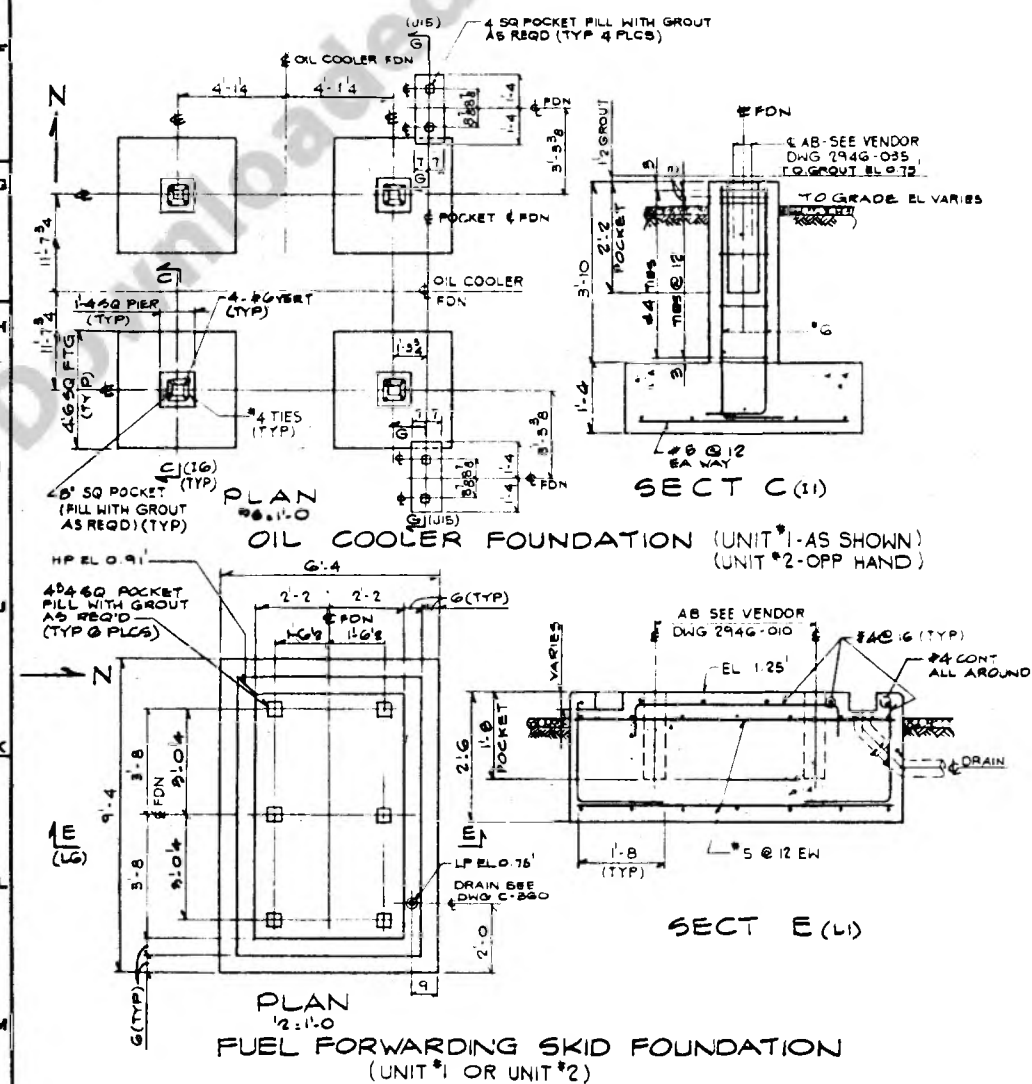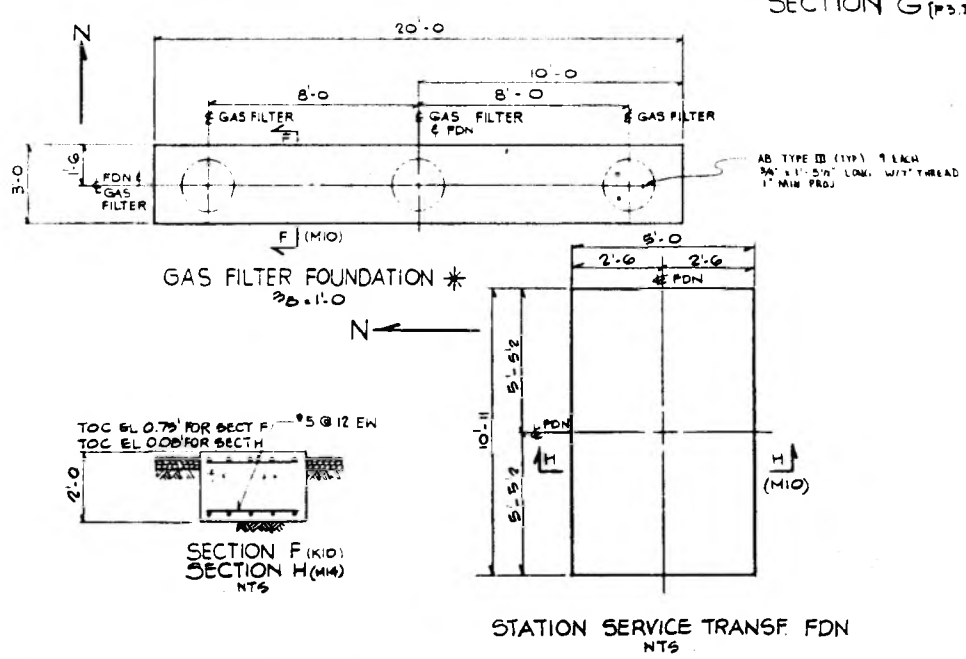

C-365

N

O

C

D

E

F

G

H

I

J

K

L

M

N

O

P

Q

R

S

T

U

V

W

X

Y

Z

AA

AB

AC

AD

AE

AF

AG

AH

AI

AJ

AK

AL

AM

AN

AO

AP

AQ

AR

AS

AT

AU

AV

AW

AX

AY

AZ

BA

BB

BC

BD

BE

BF

BG

BH

BI

BJ

BK

BL

BM

BN

BO

BP

BQ

BR

BS

BT

BU

BV

BW

BX

BY

BZ

CA

CB

CC

CD

CE

CF

CG

CH

CI

CJ

CK

CL

CM

CN

CO

CP

CQ

CR

CS

CT

CU

CV

CW

CX

CY

CZ

DA

DB

DC

DD

DE

DF

DG

DH

DI

DJ

DK

DL

DM

DN

DO

DP

DQ

DR

DS

DT

DU

DV

DW

DX

DY

DZ

EA

EB

EC

ED

EE

EF

EG

EH

EI

EJ

EK

EL

EM

EN

EO

EP

EQ

ER

ES

ET

EU

EV

EW

EX

EY

EZ

FA

FB

FC

FD

FE

FF

FG

FH

FI

FJ

FK

FL

FM

FN

FO

FP

FQ

FR

FS

FT

FU

FV

FW

FX

FY

FZ

GA

GB

GC

GD

GE

GF

GG

GH

GI

GJ

GK

GL

GM

GN

GO

GP

GQ

GR

GS

GT

GU

GV

GW

GX

GY

GZ

HA

HB

HC

HD

HE

HF

HG

HH

HI

HJ

HK

HL

HM

HN

HO

HP

HQ

HR

HS

HT

HU

HV

HW

HX

HY

HZ

IA

IB

IC

ID

IE

IF

IG

IH

II

IJ

IK

IL

IM

IN

IO

IP

IQ

IR

IS

IT

IU

IV

IW

IX

IY

IZ

JA

JB

JC

JD

JE

JF

JG

JH

JI

JJ

JK

JL

JM

JN

JO

JP

JQ

JR

JS

JT

JU

JV

JW

JX

JY

JZ

KA

KB

KC

KD

KE

KF

KG

KH

KI

KJ

KL

KM

KN

KO

KP

KQ

KR

KS

KT

KU

KV

KW

KX

KY

KZ

LA

LB

LC

LD

LE

LF

LG

LH

LI

LJ

LK

LL

LM

LN

LO

LP

LQ

LR

LS

LT

LU

LV

LW

LX

LY

LZ

MA

MB

MC

MD

ME

MF

MG

MH

MI

MJ

MK

ML

MM

MN

MO

MP

MQ

MR

MS

MT

MU

MV

MW

MX

MY

MZ

NA

NB

NC

ND

NE

NF

NG

NH

NI

NJ

NK

NL

NM

NN

NO

NP

NQ

NR

NS

NT

NU

NV

NW

NX

NY

NZ

OA

OB

OC

OD

OE

OF

OG


OH

C-366

NO	DATE	REVISION	BY	CH	APPROVED
1	7/1/85	REVISED (1) FDN. ADD (1) NOTE DELETED (1) NOTE ISSUED FOR CONSTRUCTION	SC	AP	DS
2	7/1/85	REVISED (2) PLAN (G, G, 1, 1, 1) FTO TYPE	LN	AP	DS
3	8/5/85	ADDED (1) FTO TYPE (1) FTO TYPE (1) FTO TYPE	LN	CC	OS
4	8/11/85	REVISED (1) FTO TYPE (1) FTO TYPE (1) FTO TYPE	LN	CC	OS
5	8/14/85	ADDED (1) FTO TYPE (1) FTO TYPE (1) FTO TYPE	LN	AP	DS
6	8/14/85	REVISED (1) FTO TYPE (1) FTO TYPE (1) FTO TYPE	LN	SC	NH
7	8/17/85	REVISED (1) FTO TYPE (1) FTO TYPE (1) FTO TYPE	LN	AP	DS

NOTES:
FOR GENERAL NOTES SEE DWG. C-360
PLANT EL. 120.00' EQUALS DATUM EL. 0.00'
ELEVATIONS SHOWN ON EASCO DWGS FOR GRADE AND TOP OF FOUNDATIONS TAKE PRECEDENCE OVER ELEVATIONS SHOWN ON MANUFACTURER'S DWGS.
FOR ADDITIONAL NOTES SEE DWG. C-361

REFERENCE DRAWINGS:
AREA GRADING, DRAINAGE, ACCESS ROAD AND FOUNDATION PLAN C-360
TURBINE GENERATOR FDN SECTS & DETS C-361
TURBINE GENERATOR FDN ANCHOR BOLTS & MISC. FDN C-362
MISC. FDN AND DETAILS C-363

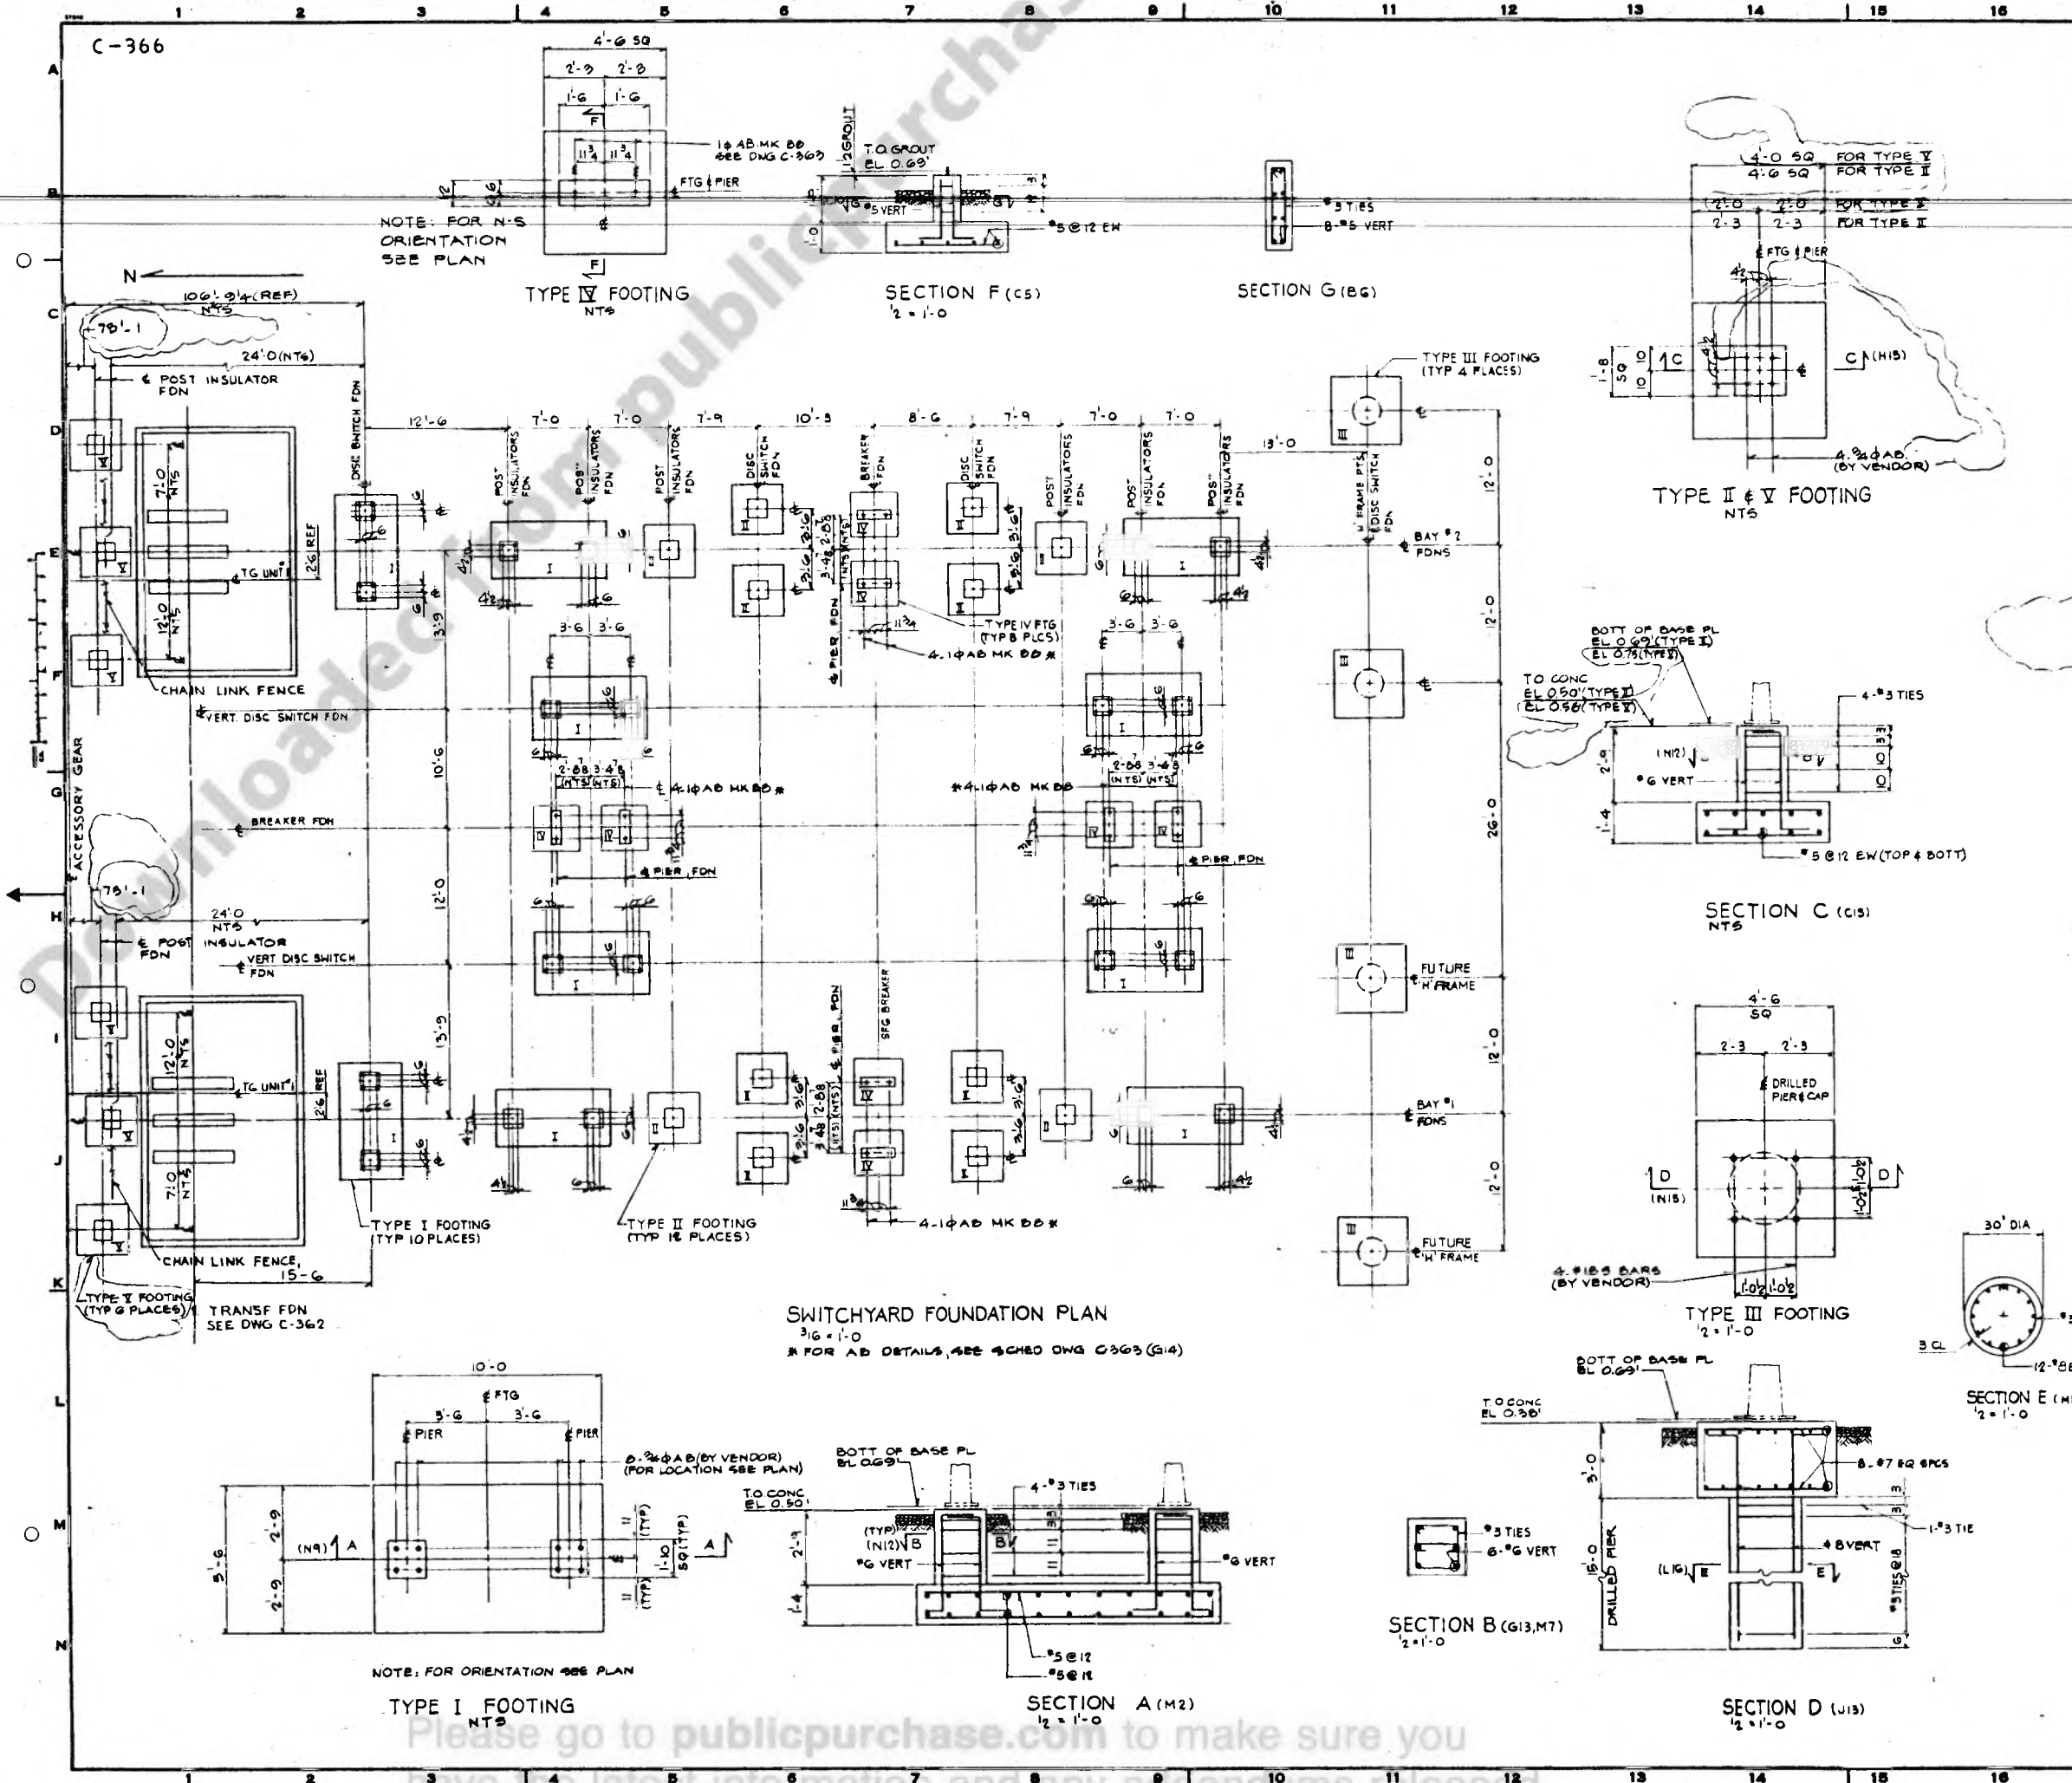

NORTHERN CALIFORNIA POWER AGENCY
PEAKING COMBUSTION TURBINE PROJECT
ROSEVILLE, CALIFORNIA
1985-24.8 MW FOR UNIT 1
1986-24.8 MW FOR UNIT 2

SWITCHYARD FOUNDATION PLAN
SECTIONS AND DETAILS

EASCO SERVICES INCORPORATED

SCALE AS NOTED	APPROVED	DATE 5-3-85
DIV. CIVIL	at pm	NCPA-2946
DR. C.C.C.	at pm	C-366
CH. R.C.R.	at pm	

E-262

N

NO	DATE	REVISION	BY	CH	APPROVED
1	7-12-85		LG	VP	[Signature]
ADDED (11) F.O. TANK, STAIRWAY LTR; REVISED (68) QUANTITY (14) EQUIP. LOCATION					
2	8-5-85		VP	VP	[Signature]
RELOCATED 5TH DERV. XPWR. A (E3) REVISED LTR. A, C, D, E, F, G, H, I, J, K, L, M, N, O, P, Q, R, S, T, U, V, W, X, Y, Z, AA, AB, AC, AD, AE, AF, AG, AH, AI, AJ, AK, AL, AM, AN, AO, AP, AQ, AR, AS, AT, AU, AV, AW, AX, AY, AZ, BA, BB, BC, BD, BE, BF, BG, BH, BI, BJ, BK, BL, BM, BN, BO, BP, BQ, BR, BS, BT, BU, BV, BW, BX, BY, BZ, CA, CB, CC, CD, CE, CF, CG, CH, CI, CJ, CK, CL, CM, CN, CO, CP, CQ, CR, CS, CT, CU, CV, CW, CX, CY, CZ, DA, DB, DC, DD, DE, DF, DG, DH, DI, DJ, DK, DL, DM, DN, DO, DP, DQ, DR, DS, DT, DU, DV, DW, DX, DY, DZ, EA, EB, EC, ED, EE, EF, EG, EH, EI, EJ, EK, EL, EM, EN, EO, EP, EQ, ER, ES, ET, EU, EV, EW, EX, EY, EZ, FA, FB, FC, FD, FE, FF, FG, FH, FI, FJ, FK, FL, FM, FN, FO, FP, FQ, FR, FS, FT, FU, FV, FW, FX, FY, FZ, GA, GB, GC, GD, GE, GF, GG, GH, GI, GJ, GK, GL, GM, GN, GO, GP, GQ, GR, GS, GT, GU, GV, GW, GX, GY, GZ, HA, HB, HC, HD, HE, HF, HG, HH, HI, HJ, HK, HL, HM, HN, HO, HP, HQ, HR, HS, HT, HU, HV, HW, HX, HY, HZ, IA, IB, IC, ID, IE, IF, IG, IH, II, IJ, IK, IL, IM, IN, IO, IP, IQ, IR, IS, IT, IU, IV, IW, IX, IY, IZ, JA, JB, JC, JD, JE, JF, JG, JH, JI, JJ, JK, JL, JM, JN, JO, JP, JQ, JR, JS, JT, JU, JV, JW, JX, JY, JZ, KA, KB, KC, KD, KE, KF, KG, KH, KI, KJ, KK, KL, KM, KN, KO, KP, KQ, KR, KS, KT, KU, KV, KW, KX, KY, KZ, LA, LB, LC, LD, LE, LF, LG, LH, LI, LJ, LK, LL, LM, LN, LO, LP, LQ, LR, LS, LT, LU, LV, LW, LX, LY, LZ, MA, MB, MC, MD, ME, MF, MG, MH, MI, MJ, MK, ML, MM, MN, MO, MP, MQ, MR, MS, MT, MU, MV, MW, MX, MY, MZ, NA, NB, NC, ND, NE, NF, NG, NH, NI, NJ, NK, NL, NM, NN, NO, NP, NQ, NR, NS, NT, NU, NV, NW, NX, NY, NZ, OA, OB, OC, OD, OE, OF, OG, OH, OI, OJ, OK, OL, OM, ON, OO, OP, OQ, OR, OS, OT, OU, OV, OW, OX, OY, OZ, PA, PB, PC, PD, PE, PF, PG, PH, PI, PJ, PK, PL, PM, PN, PO, PP, PQ, PR, PS, PT, PU, PV, PW, PX, PY, PZ, QA, QB, QC, QD, QE, QF, QG, QH, QI, QJ, QK, QL, QM, QN, QO, QP, QQ, QR, QS, QT, QU, QV, QW, QX, QY, QZ, RA, RB, RC, RD, RE, RF, RG, RH, RI, RJ, RK, RL, RM, RN, RO, RP, RQ, RR, RS, RT, RU, RV, RW, RX, RY, RZ, SA, SB, SC, SD, SE, SF, SG, SH, SI, SJ, SK, SL, SM, SN, SO, SP, SQ, SR, SS, ST, SU, SV, SW, SX, SY, SZ, TA, TB, TC, TD, TE, TF, TG, TH, TI, TJ, TK, TL, TM, TN, TO, TP, TQ, TR, TS, TT, TU, TV, TW, TX, TY, TZ, UA, UB, UC, UD, UE, UF, UG, UH, UI, UJ, UK, UL, UM, UN, UO, UP, UQ, UR, US, UT, UY, UZ, VA, VB, VC, VD, VE, VF, VG, VH, VI, VJ, VK, VL, VM, VN, VO, VP, VQ, VR, VS, VT, VU, VV, VW, VX, VY, VZ, WA, WB, WC, WD, WE, WF, WG, WH, WI, WJ, WK, WL, WM, WN, WO, WP, WQ, WR, WS, WT, WU, WV, WW, WX, WY, WZ, XA, XB, XC, XD, XE, XF, XG, XH, XI, XJ, XK, XL, XM, XN, XO, XP, XQ, XR, XS, XT, XU, XV, XW, XX, XY, XZ, YA, YB, YC, YD, YE, YF, YG, YH, YI, YJ, YK, YL, YM, YN, YO, YP, YQ, YR, YS, YT, YU, YV, YW, YX, YY, YZ, ZA, ZB, ZC, ZD, ZE, ZF, ZG, ZH, ZI, ZJ, ZK, ZL, ZM, ZN, ZO, ZP, ZQ, ZR, ZS, ZT, ZU, ZV, ZW, ZX, ZY, ZZ					
3	8-20-85		LG	VP	[Signature]
REVISED (14) EQUIP. LOCATION AT NEW AIR COMPRESSOR					
4	10-1-85	AS BUILT			[Signature]

SYMBOLS

- MOS-013 - SEE DETAIL 1, DWG. E-269
- MOS-014 - SEE DETAIL 2, DWG. E-269
- MOS-015 - SEE DETAIL 3, DWG. E-269
- MOS-016 - SEE DETAIL 4, DWG. E-269
- T-1 - PANEL NUMBER
- CIRCUIT NUMBER

NOTES

1. THE LOCATION OF ALL FIXTURES AND OUTLETS ARE SHOWN TO SCALE. FIELD SHALL ADHERE TO LOCATIONS INDICATED ON THIS DRAWING UNLESS INTERFERENCE MAKES RELOCATION NECESSARY.
2. BRANCH CIRCUIT WIRING BETWEEN JUNCTION POINTS AND REMAINING FIXTURES AND RECEPTACLES IS NOT SHOWN ON THIS DRAWING. THE REQUIRED CIRCUIT RUNS SHALL BE DETERMINED IN THE FIELD BASED ON ARRANGEMENT AND CIRCUITING.
3. ALL BRANCH CIRCUITS SHALL BE #18 AWG EXCEPT AS FOLLOWS:
CIRCUITS 1, 2, 3, 4, 5 & 7 SHALL BE #6 AWG FROM DP1 TO JB AND FROM JB TO LTC POLE TERMINALS (AS SHOWN)
4. CABLES FROM JB'S TO FIXTURES AND RECEPTACLES SHALL BE DIRECT BURIED AT A MINIMUM OF 1'-6" BELOW GRADE IN THE CENTER OF AT LEAST 1'-0" OF SAND BACKFILL. CREOSOTED PLANKING, PRECAST CONCRETE SLABS OR OTHER SUITABLE MATERIAL SHALL BE LAID DIRECTLY OVER THE SAND AND COVERED WITH STONEFREE COMPACTED DIRT. RUNS UNDER ROADWAYS SHALL BE IN RIGID GALVANIZED STEEL (RGS) CONDUIT.
5. WHERE CABLES ARE REQUIRED TO EXIT UNDERGROUND, THEY SHALL BE RUN IN EXPOSED RGS CONDUIT AS REQUIRED.
6. MINIMUM CONDUIT SIZE SHALL BE 1/2 INCH.
7. DISTRIBUTION PANEL DP1 IS LOCATED IN THE STATION SERVICE MCC WHICH IS LOCATED IN THE BOP ELECTRICAL ROOM (BOPER).
8. POLE MTD FIXTURES ALONG ROADWAY SHALL BE SET BACK 4'-0" FROM THE EDGE OF ROADWAY.
9. ALL LTC POLE FOUNDATIONS SHALL BE POURED WITH A #2 AWG BARE COPPER GROUND CABLE EXTENDING 2'-0" MIN ABOVE FOUNDATIONS. SEE DETAIL 1, DWG. E-269.
10. FOR DETAIL INSTALLATION OF DIRECT BURIAL LTC CABLES AND LTC FIXTURES SEE DWG. E-269.

REFERENCE DRAWINGS


LIGHTING NOTES AND DETAILS - E-269
BILL OF MATERIAL - E-271

REV 4

NORTHERN CALIFORNIA POWER AGENCY
PEAKING COMBUSTION TURBINE PROJECT
ROSEVILLE, CALIFORNIA
1985-24.8 MW INSTALLATION
1986-24.8 MW ADDITION
STATION LIGHTING

EBASCO SERVICES INCORPORATED

SCALE: 1/4" = 1'-0"	APPROVED: [Signature]	DATE: APR 15, 1989
DIVISION: ELECTRICAL	DR. L. GILL	NCPA-2946
CH. D. AMATO	[Signature]	E-262

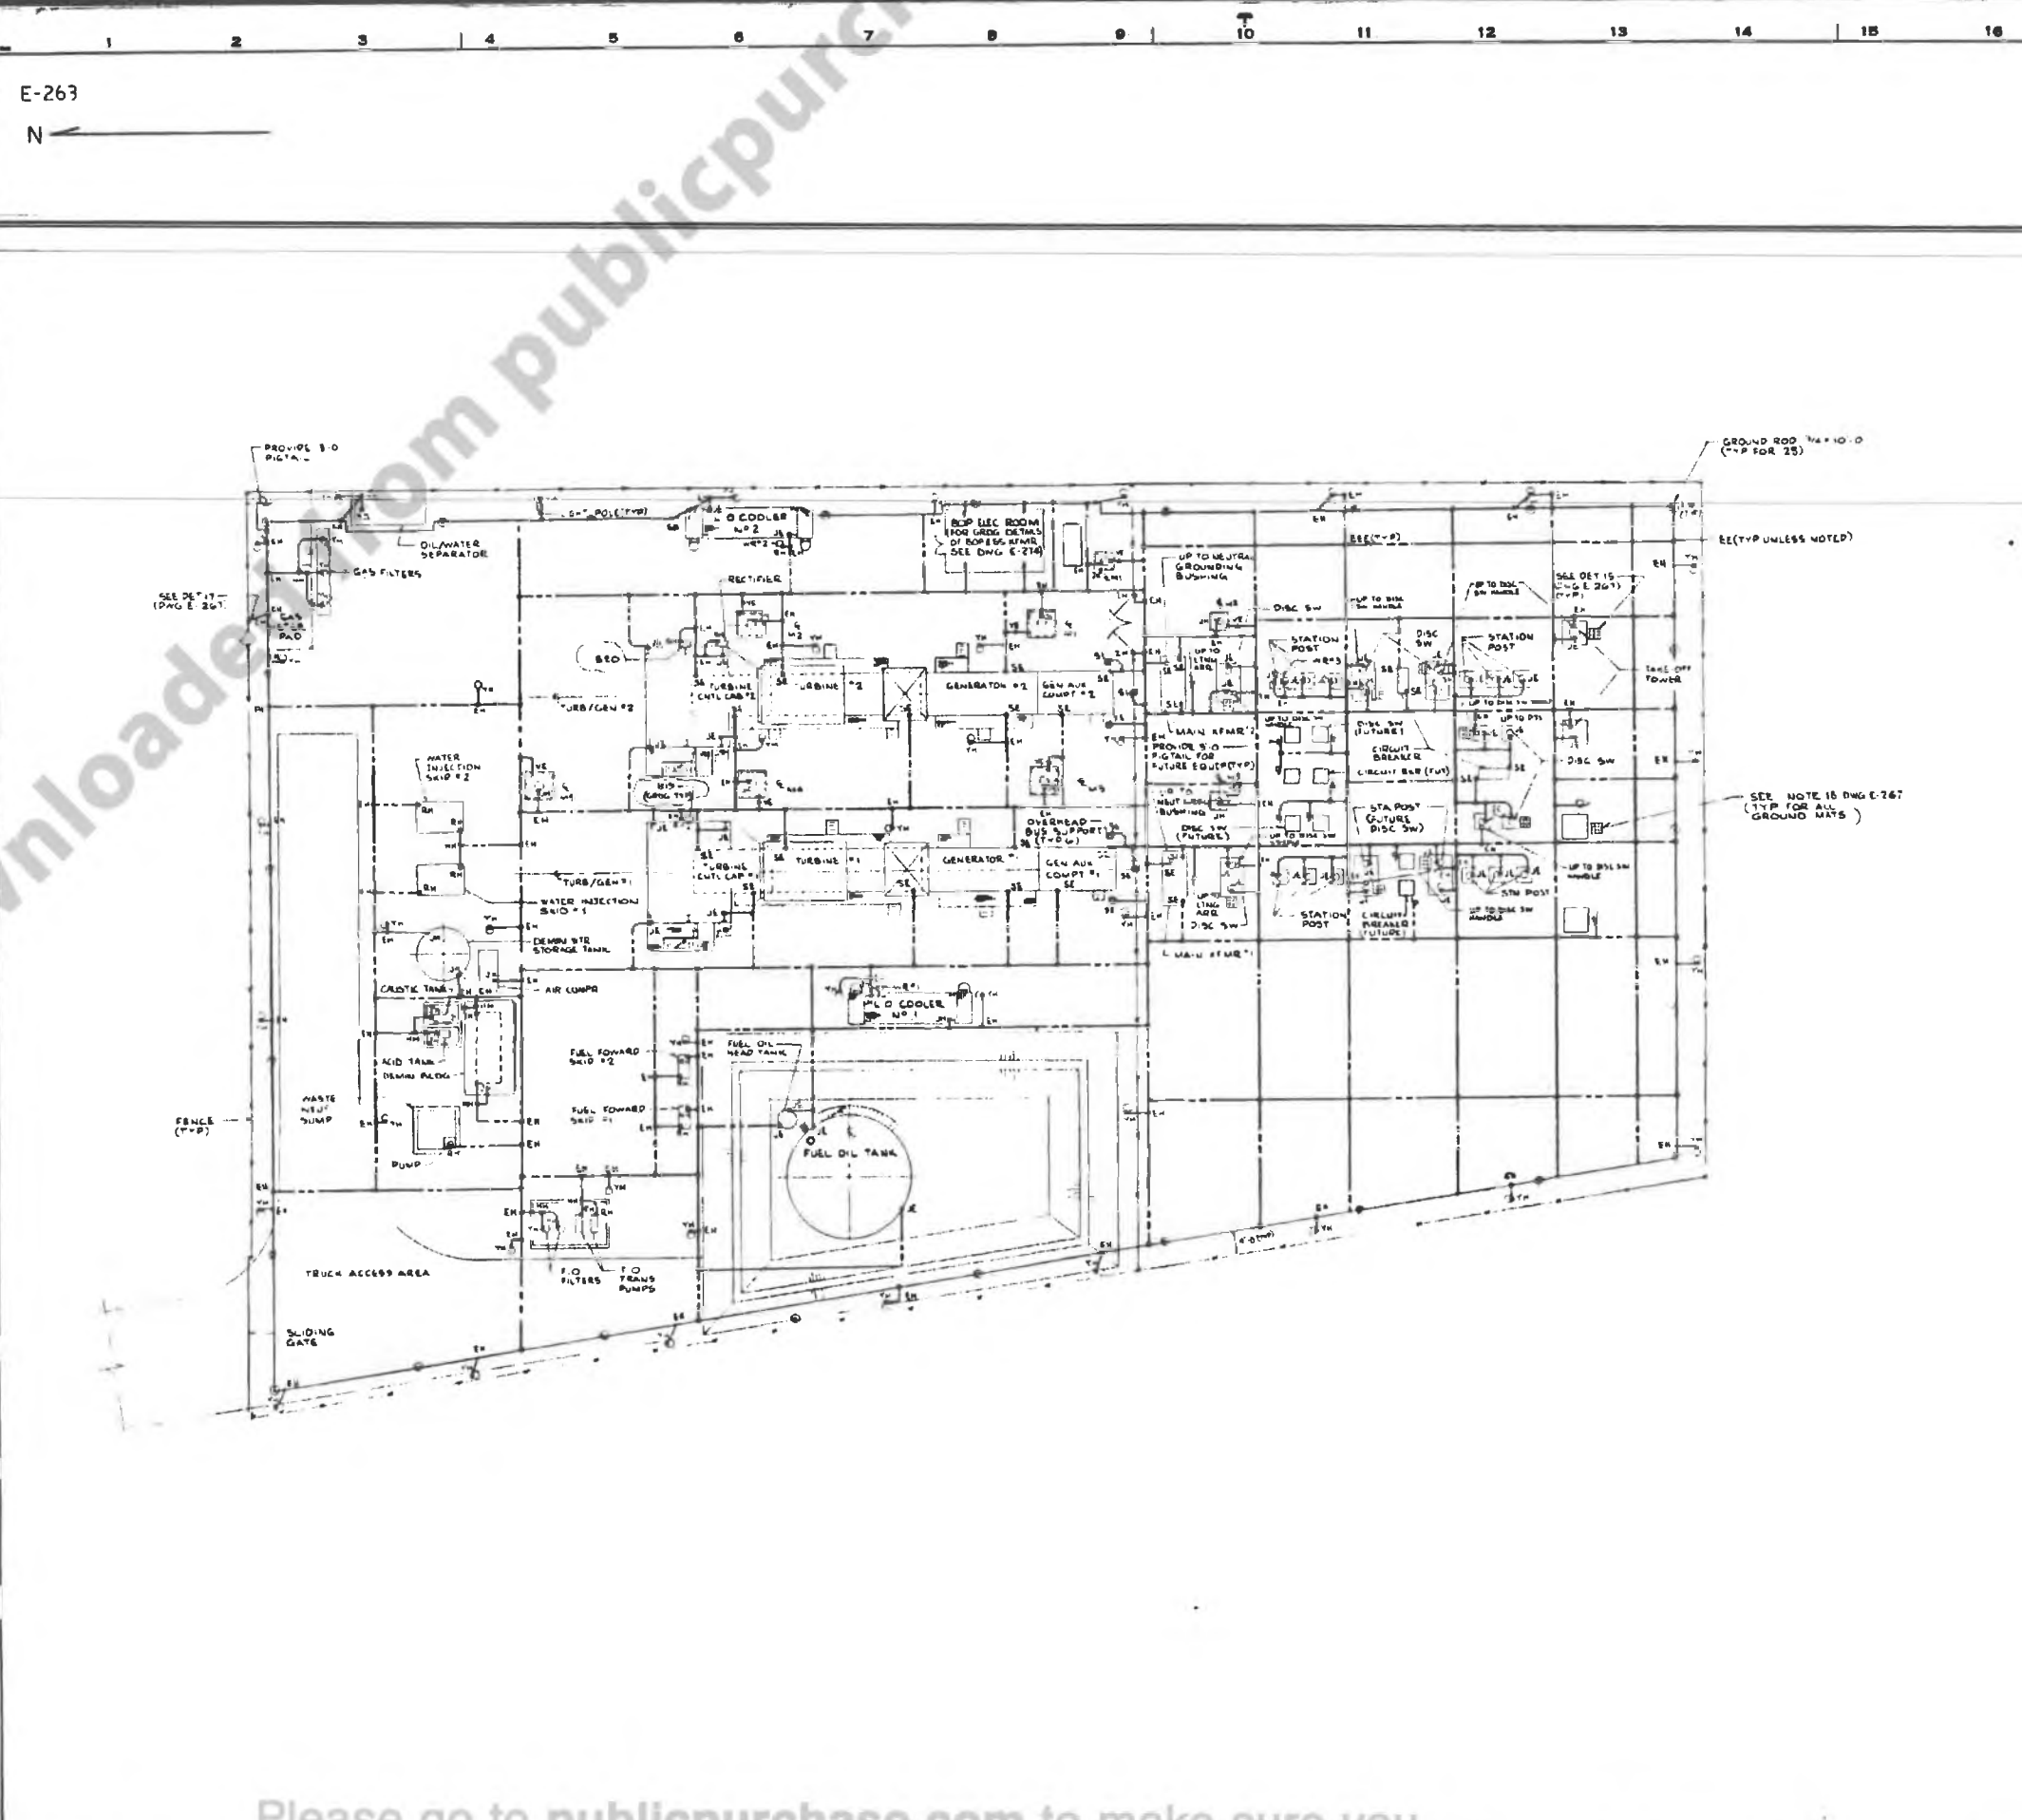

NO	DATE	REVISION	BY	CH	APPROVED
1	5-5-85		VP	VP	[Signature]
RELOCATED: STN. SERV. SFMR (09)					
REVISED: GRDG. AT MANHOLES M1 (E8) M2 (E6) M3 (G8) M4 (H8)					
HANDHOLE M1 (E8) M2 (E10) M3 (G10)					
ADDED: GRDG. TO DISC SW. MANHOLES (110)(111)(112)(113)(114)					
NOTE TO GRD MAT (G14)					
2	5-15-85		LG	VP	[Signature]
ADDED: (1-0 G-0) GROUNDING TO NEXT GRD. BUSING					
3	5-15-85		VP	VP	[Signature]
ADDED: (1-0 G-0) GRDG. AT MAIN LEADS SUPPORT STRUCT.					
4	5-30-85		VP	VP	[Signature]
REVISED: GROUND MAT LOCATION (G12)					
5	5-2-85		VP	VP	[Signature]
ADDED: BOX N° 15 (G5)					
6	5/12/87	AS BUILT			[Signature]

NOTE:
FOR NOTES AND REFERENCE DRAWINGS
SEE DRAWING E-267



REV 6

NORTHERN CALIFORNIA POWER AGENCY
PEAKING COMBUSTION TURBINE PROJECT
ROSEVILLE, CALIFORNIA
1985-24.8 MW INSTALLATION
1986-24.8 MW ADDITION

STATION GROUNDING

EBASCO SERVICES INCORPORATED

SCALE: 1/8" = 1'-0"

APPROVED: [Signature]

DATE: JULY 12, 1985

DR. L. GILL

CH. V. PRICE

NCPA-2946

E-263